Sheet index

7 source pages / 2 matched pairs / 0 exceptions

All supplied pages accounted for

Each source page has one entry in this register.

REF	SHEET ID	SOURCE / PAGE	DISPOSITION	PAIR / DETAIL
B1	**Q-801**	hard-baseline.pdf / p. 1	PAIRED	B1 + U3
B2	**Q-802**	hard-baseline.pdf / p. 2	NO REPLACEMENT SUPPLIED	Retain prior sheet
B3	**Q-803**	hard-baseline.pdf / p. 3	PAIRED	B3 + U1
B4	**Q-804**	hard-baseline.pdf / p. 4	NO REPLACEMENT SUPPLIED	Retain prior sheet
U1	**Q-803**	hard-partial.pdf / p. 1	PAIRED	B3 + U1
U2	**Q-805**	hard-partial.pdf / p. 2	NEW / UNMATCHED	No unique predecessor
U3	**Q-801**	hard-partial.pdf / p. 3	PAIRED	B1 + U3

B = baseline. U = supplied update. New / unmatched is relative to this baseline.

An omitted sheet remains in the working set. Check written addenda for withdrawals and scope changes.

Paired source views


Q-803 / B3 + U1 / Same unique labelled title-block ID

BASELINE

hard-baseline.pdf / p. 3

See Q-802 for coordination.

SHEET NUMBER: Q-803

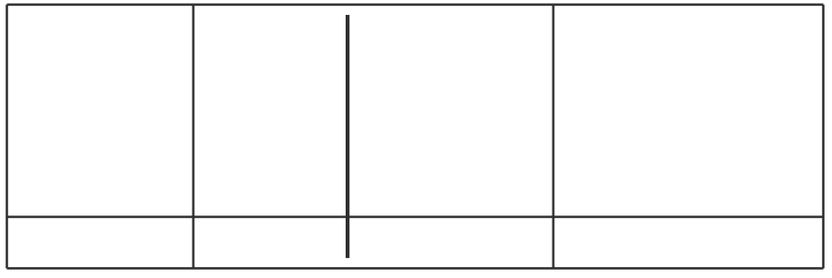

Finish note: Ceramic


SYNTHETIC TEST - NOT FOR CONSTRUCTION

PARTIAL UPDATE

hard-partial.pdf / p. 1

See Q-802 for coordination.

SHEET NUMBER: Q-803

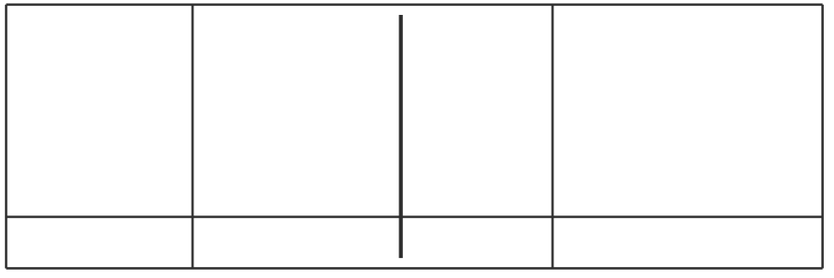

Finish note: Terrazzo

SYNTHETIC TEST - NOT FOR CONSTRUCTION

Registration check passed

Distributed drawing strokes coincide at the original page coordinates.

Visual differences

Q-803 / hard-baseline.pdf / p. 3 to hard-partial.pdf / p. 1



INK KEY

- Baseline only
- Update only
- Shared ink

EXTRACTED TEXT DIFFERENCES

Baseline only

Finish note: Ceramic

Update only

Finish note: Terrazzo

Colors show visible ink at this render scale. Review the sources and written addendum before deciding bid impact.

Before / after text

Q-803 / B3 + U1 / Difference detail 1 of 1

BASELINE ONLY

hard-baseline.pdf / p. 3

Finish note: Ceramic

UPDATE ONLY

hard-partial.pdf / p. 1

Finish note: Terrazzo

Vector stroke positions / points from top left

(x0, y0) to (x1, y1): 350, 153, 350, 342

(x0, y0) to (x1, y1): 392, 153, 392, 342

Extracted lines and selected long axis-aligned strokes; not an exhaustive change or engineering review.

Paired source views


Q-801 / B1 + U3 / Same unique labelled title-block ID

BASELINE

hard-baseline.pdf / p. 1

See Q-802 for coordination.

SHEET NUMBER: Q-801

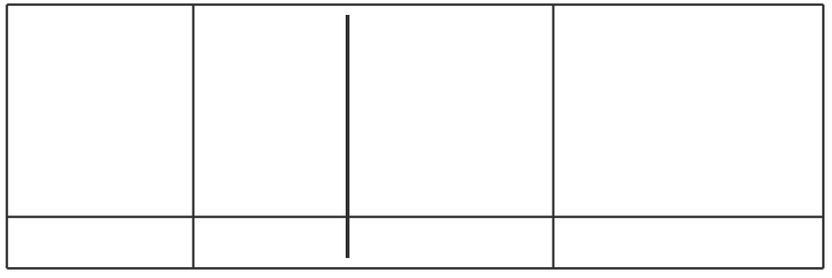

Finish note: Ceramic


SYNTHETIC TEST - NOT FOR CONSTRUCTION

PARTIAL UPDATE

hard-partial.pdf / p. 3

See Q-802 for coordination.

SHEET NUMBER: Q-801

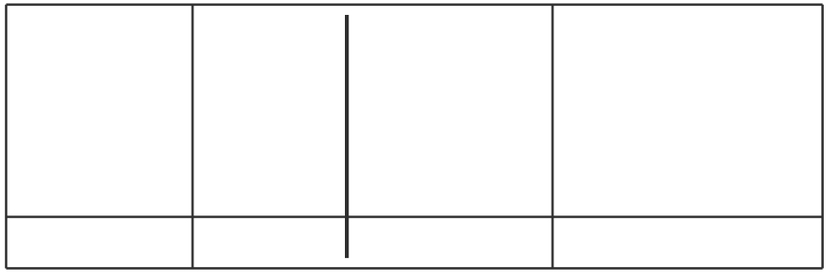

Finish note: Ceramic


SYNTHETIC TEST - NOT FOR CONSTRUCTION

Registration check passed

Distributed drawing strokes coincide at the original page coordinates.

Visual differences

Q-801 / hard-baseline.pdf / p. 1 to hard-partial.pdf / p. 3

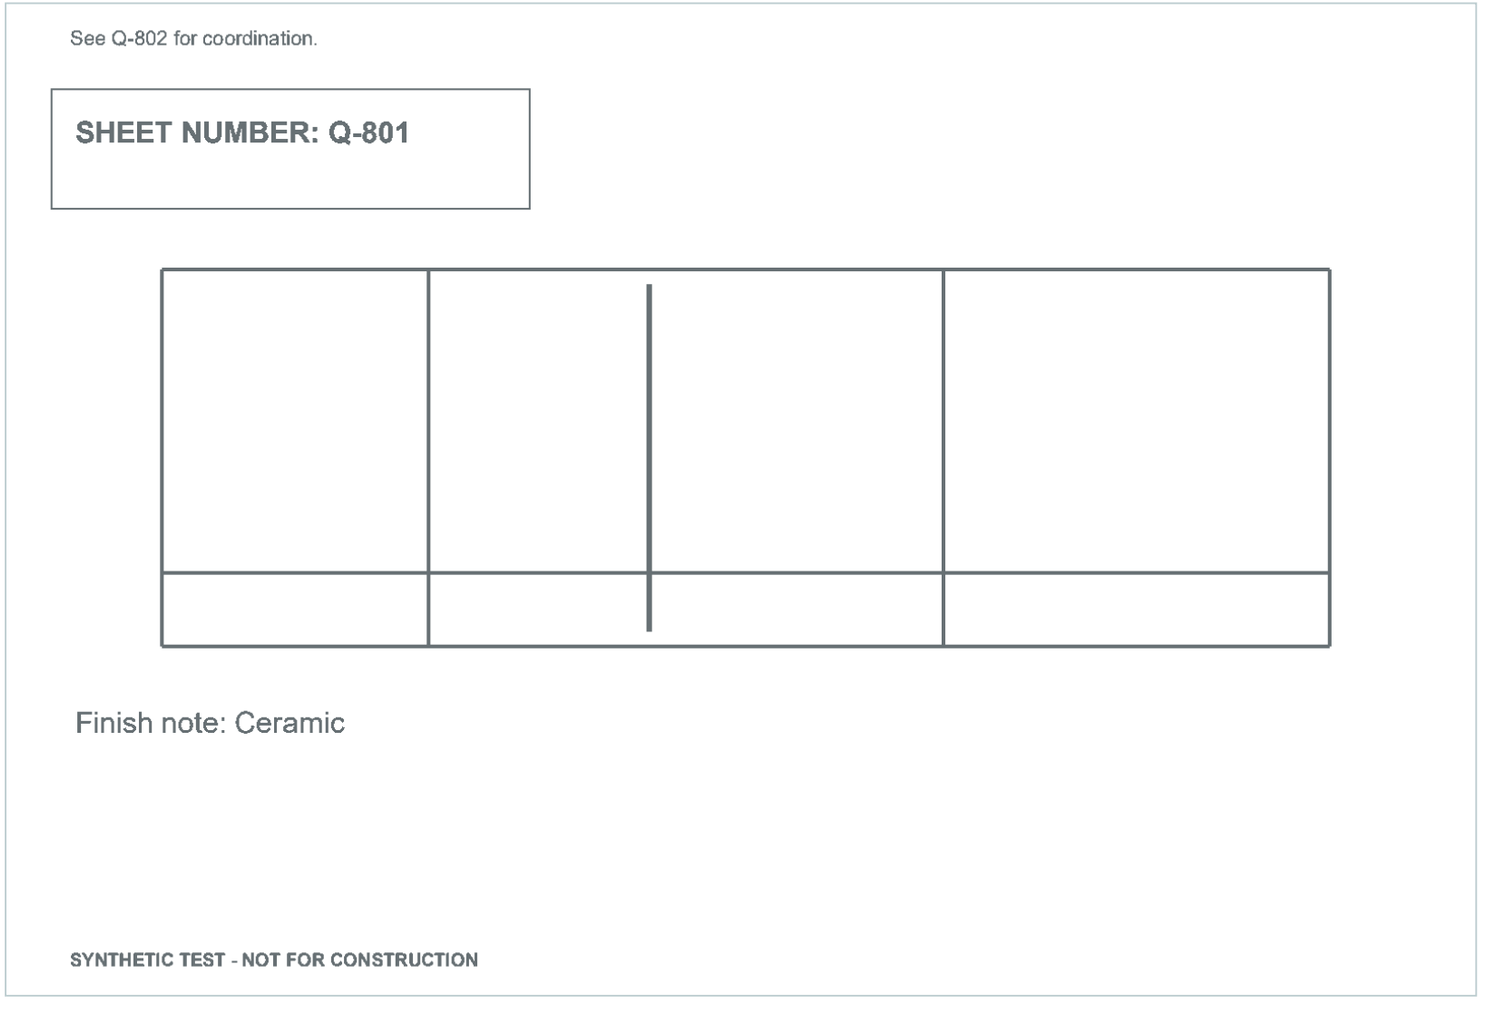

INK KEY

- Baseline only
- Update only
- Shared ink

EXTRACTED TEXT DIFFERENCES

Baseline only

No distinct text line

Update only

No distinct text line

Colors show visible ink at this render scale. Review the sources and written addendum before deciding bid impact.

Before / after text

Q-801 / B1 + U3 / Difference detail 1 of 1

BASELINE ONLY

hard-baseline.pdf / p. 1

No distinct extracted text line

UPDATE ONLY

hard-partial.pdf / p. 3

No distinct extracted text line

Vector stroke positions / points from top left

Extracted lines and selected long axis-aligned strokes; not an exhaustive change or engineering review.

Exception register

Resolve flagged issues against the source pages before relying on a comparison.

No automatic exceptions

The labelled IDs were unique and the paired sheet met the fixed-coordinate registration check. A passing check does not certify that every drawing or written change was found.

Estimator impact log

Complete this page after reviewing the drawings, the written addendum and the exceptions.

ESTIMATOR _____ **REVIEW DATE** _____

SHEET / SOURCE	OBSERVATION OR SCOPE QUESTION	BID IMPACT / DECISION	OWNER / FOLLOW-UP

Record quantities, pricing and decisions only after your own review.